


MONTANA FISH, WILDLIFE & PARKS

BLUEWATER SPRINGS TROUT HATCHERY 2016 ARTESIAN WELL AS-BUILTS

CARBON COUNTY, MONTANA


FWP # _____

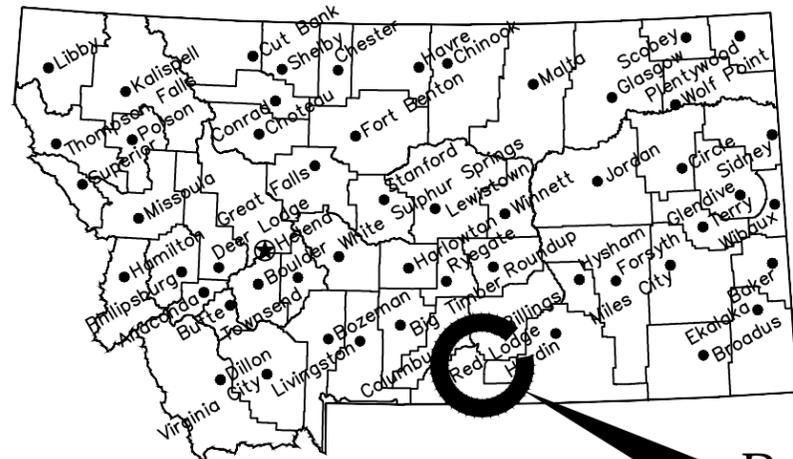

Location Map

No Scale

Project Location

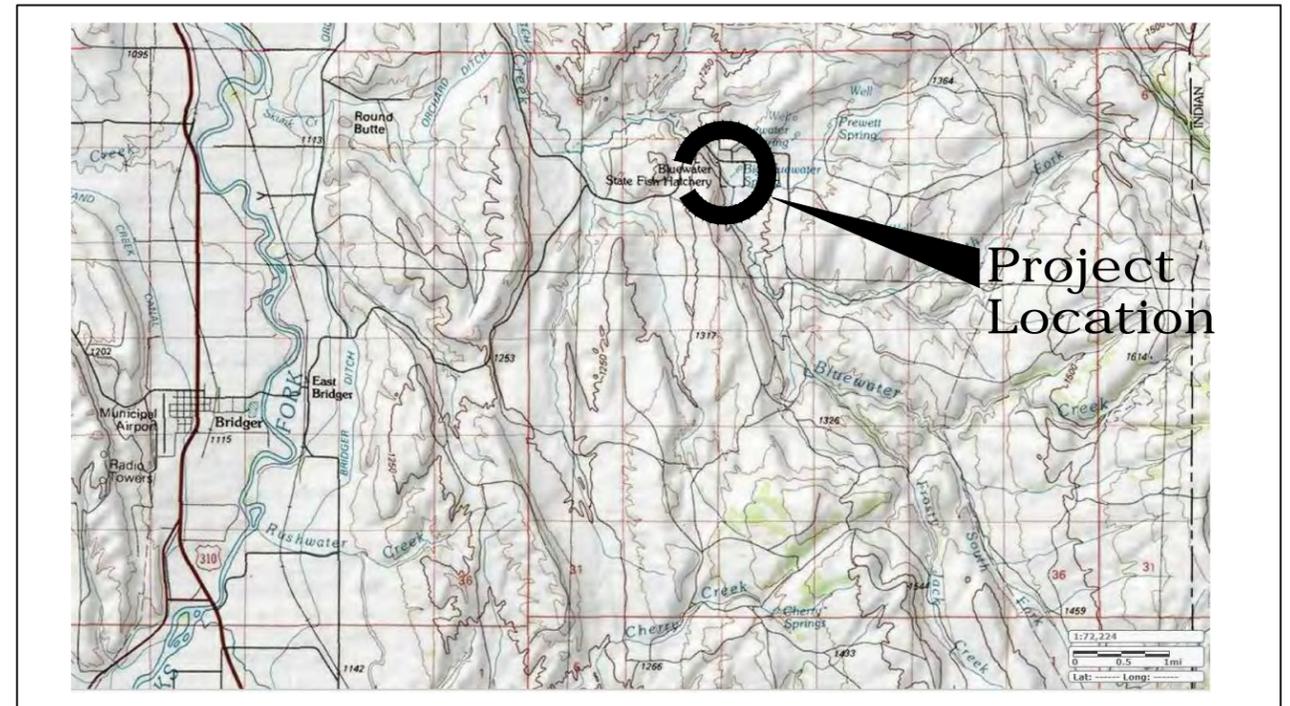

Vicinity Map

No Scale

MONTANA FISH, WILDLIFE AND PARKS
DESIGN AND CONSTRUCTION

MAILING ADDRESS: PO BOX 200701
HELENA, MT 59620-0701
TEL 406.841.4000
FAX 406.841.4004
fwp.mt.gov/Doing Business/Design&Construction

PHYSICAL ADDRESS: 1522 9th AVENUE
HELENA, MT 59601

DRAWING INDEX

- 1 COVER SHEET
- 2 EXISTING FLOOR PLAN
- 3 EXISTING WELLHEAD ELEVATIONS
- 4 TOPOGRAPHY
- 5 WELL LOG
- 6 PICTURES

?
DRAWN BY: DATE:
?
CHECKED BY: DATE:

APPROVED BY: DATE:
APPROVED BY: DATE:

APPROVED BY: DATE:
APPROVED BY: DATE:




**Montana Fish,
Wildlife & Parks**

Cover Sheet

Bluewater Trout Fish Hatchery, Bridger, Montana



SHEET: 1 of 6

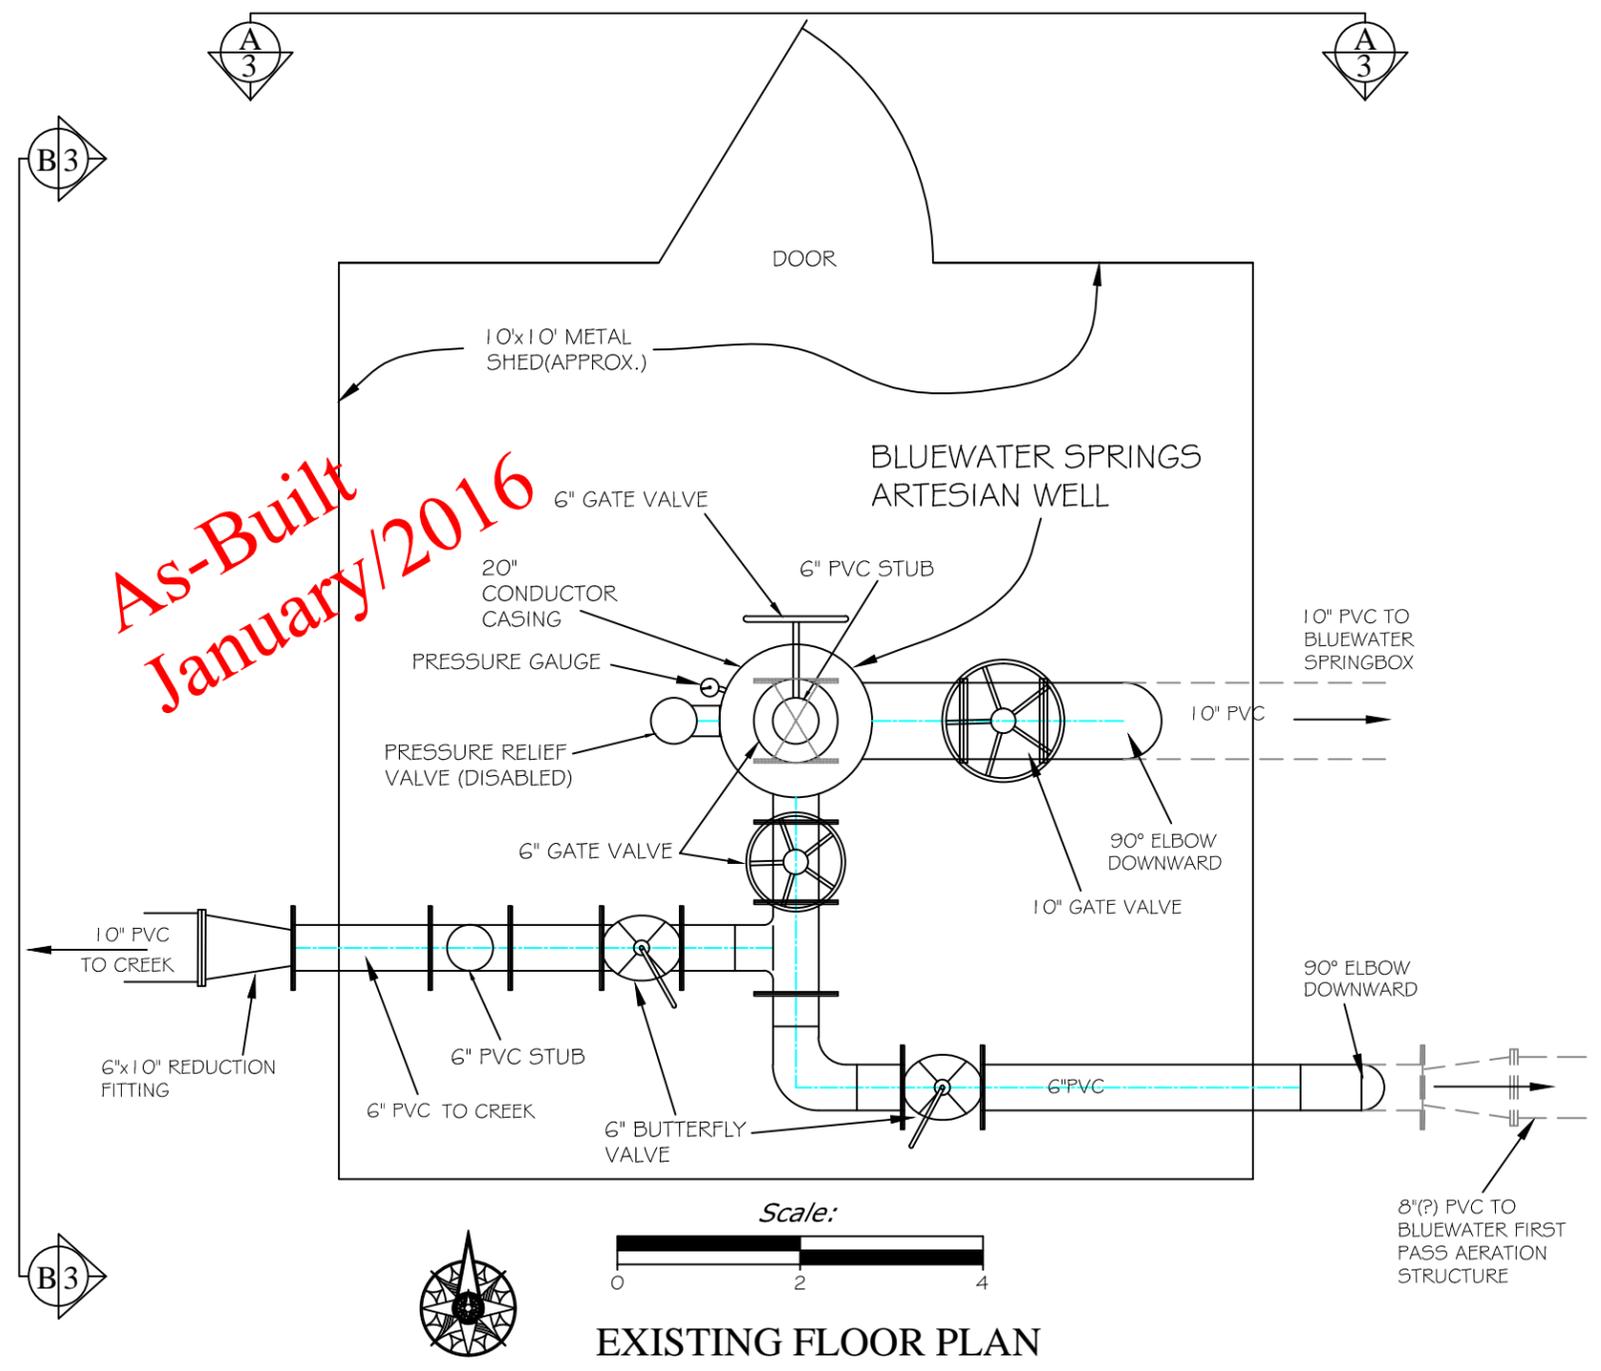

**As-Built
January/2016**

Scale:
0 2 4
EXISTING FLOOR PLAN


?	?	?	?
DRAWN BY:	DATE:	REVISED BY:	DATE:
?	?	APPROVED BY:	DATE:
CHECKED BY:	DATE:	APPROVED BY:	DATE:



BLUEWATER SPRINGS TROUT HATCHERY
ARTESIAN WELL AS-BUILTS - EXISTING FLOOR PLAN


A
3
NORTH ELEVATION

As-Built
January/2016

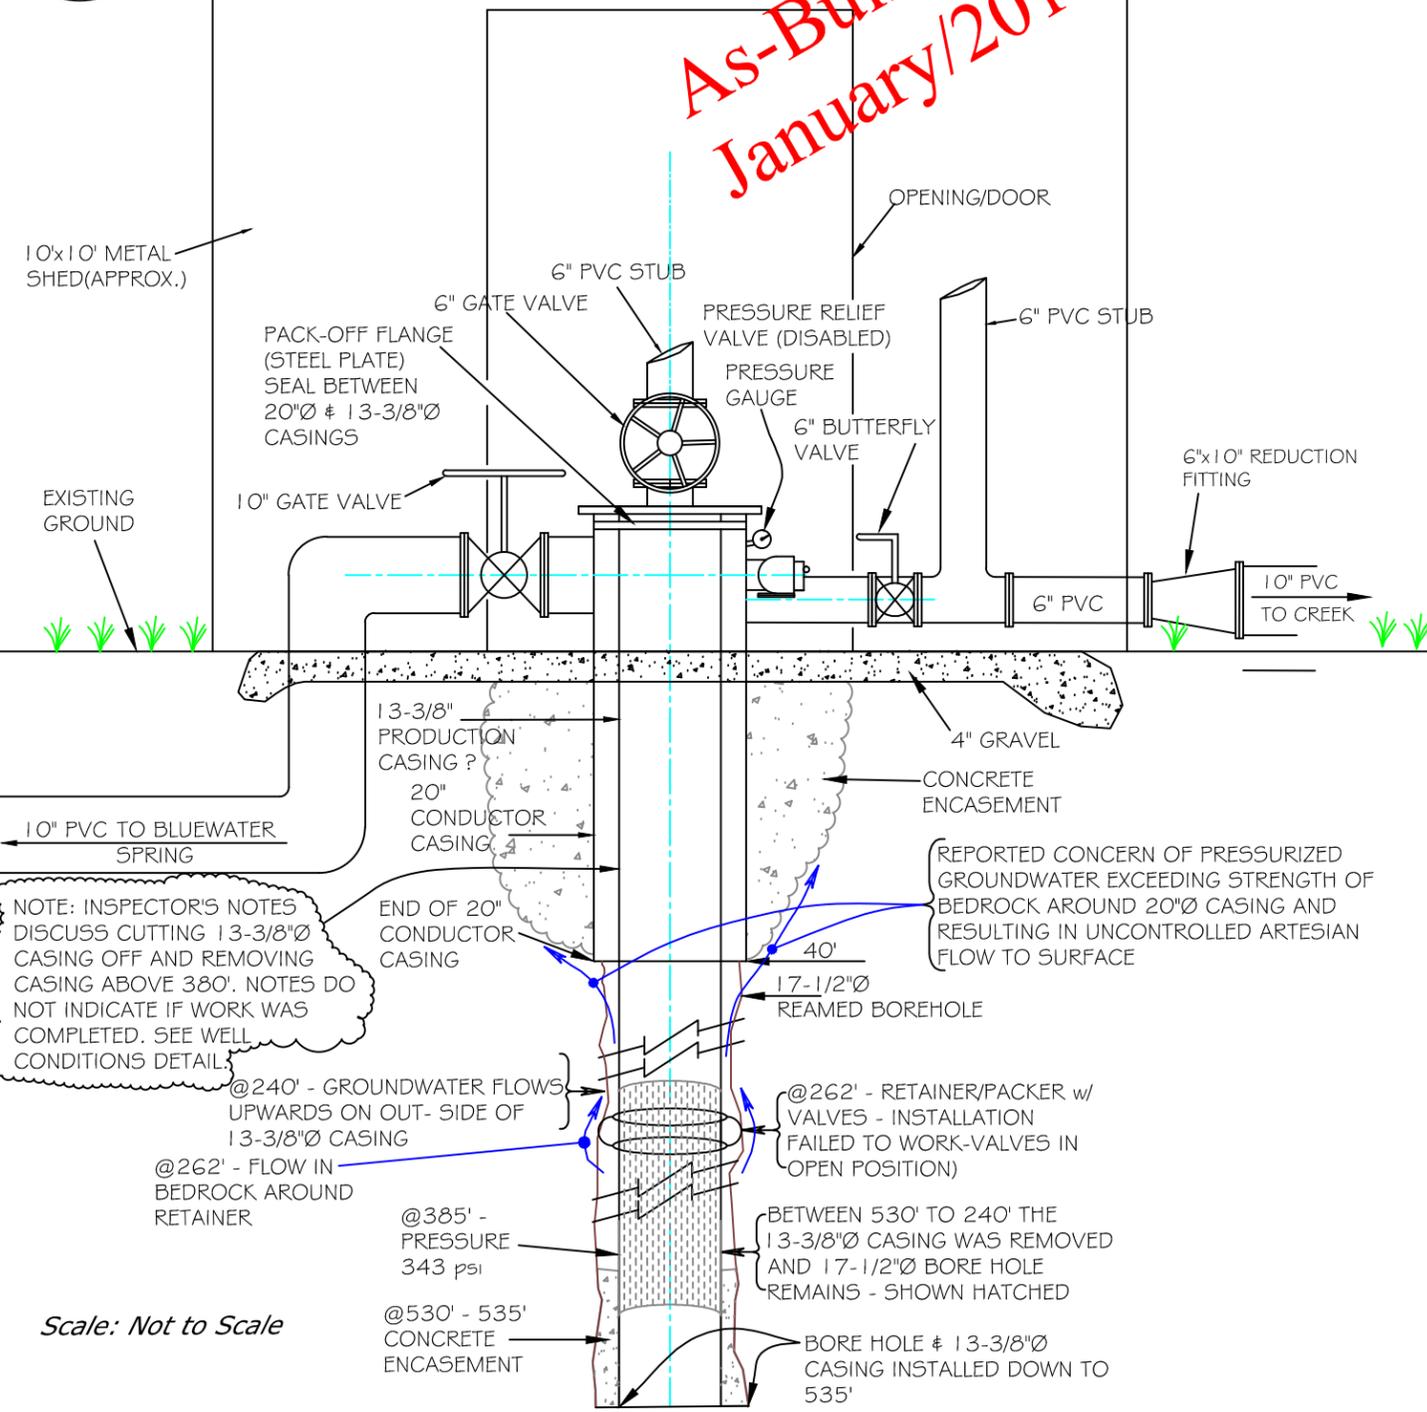

B
3
WEST ELEVATION

As-Built
January/2016


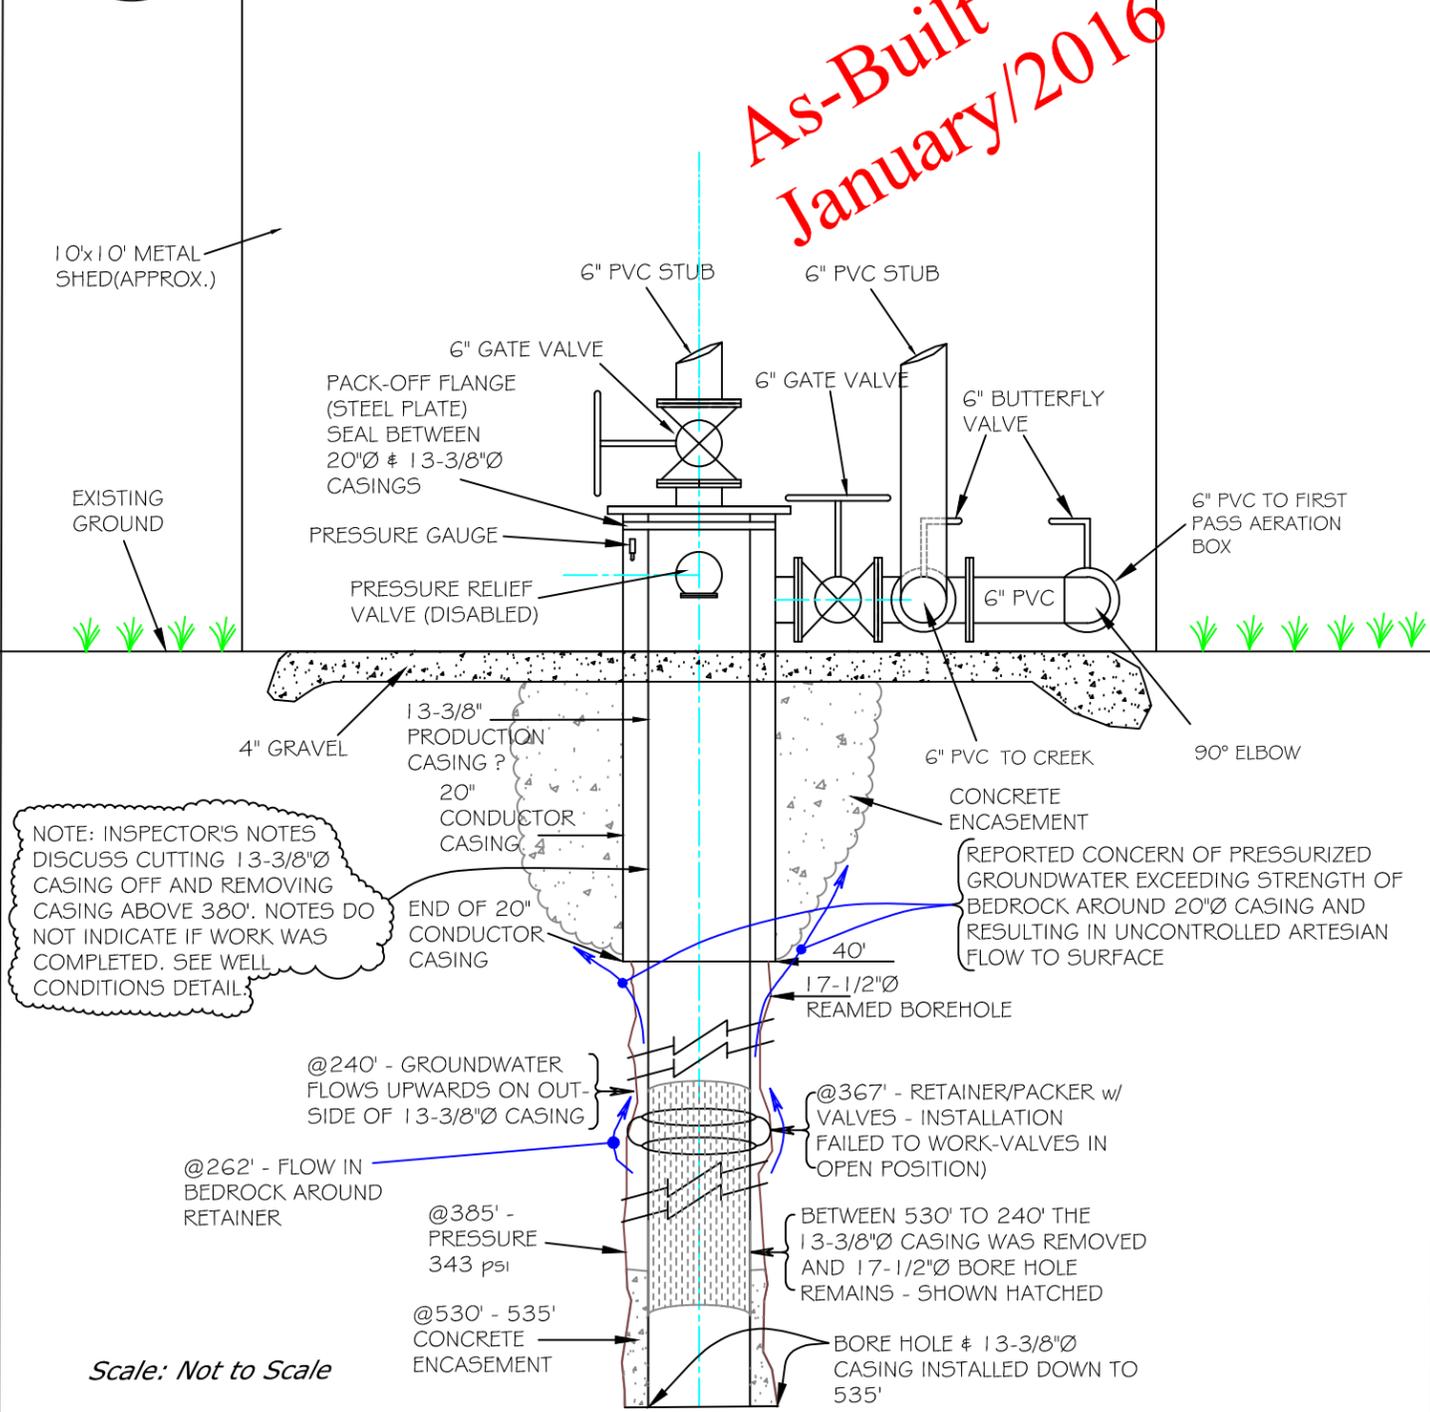


?	?	?	?
DRAWN BY:	DATE:	REVISIED BY:	DATE:
?	?	?	?
CHECKED BY:	DATE:	APPROVED BY:	DATE:



BLUEWATER SPRINGS TROUT HATCHERY
ARTESIAN WELLAS-BUILTS - EXISTING ELEVATIONS

LEGEND			
BUILDING		FLAG	
BRUSH		GRAVEL ROAD	
CATTLEGUARD		PIPE	
CONIFER TREE		POWER POLE	
CONCRETE STRUCTURE		PROPANE TANK	
CONTROL POINT		TELEPHONE PEDESTAL	
CULVERT		SATELLITE DISH	
DECIDUOUS TREE		OPEN WATER	
FENCE			

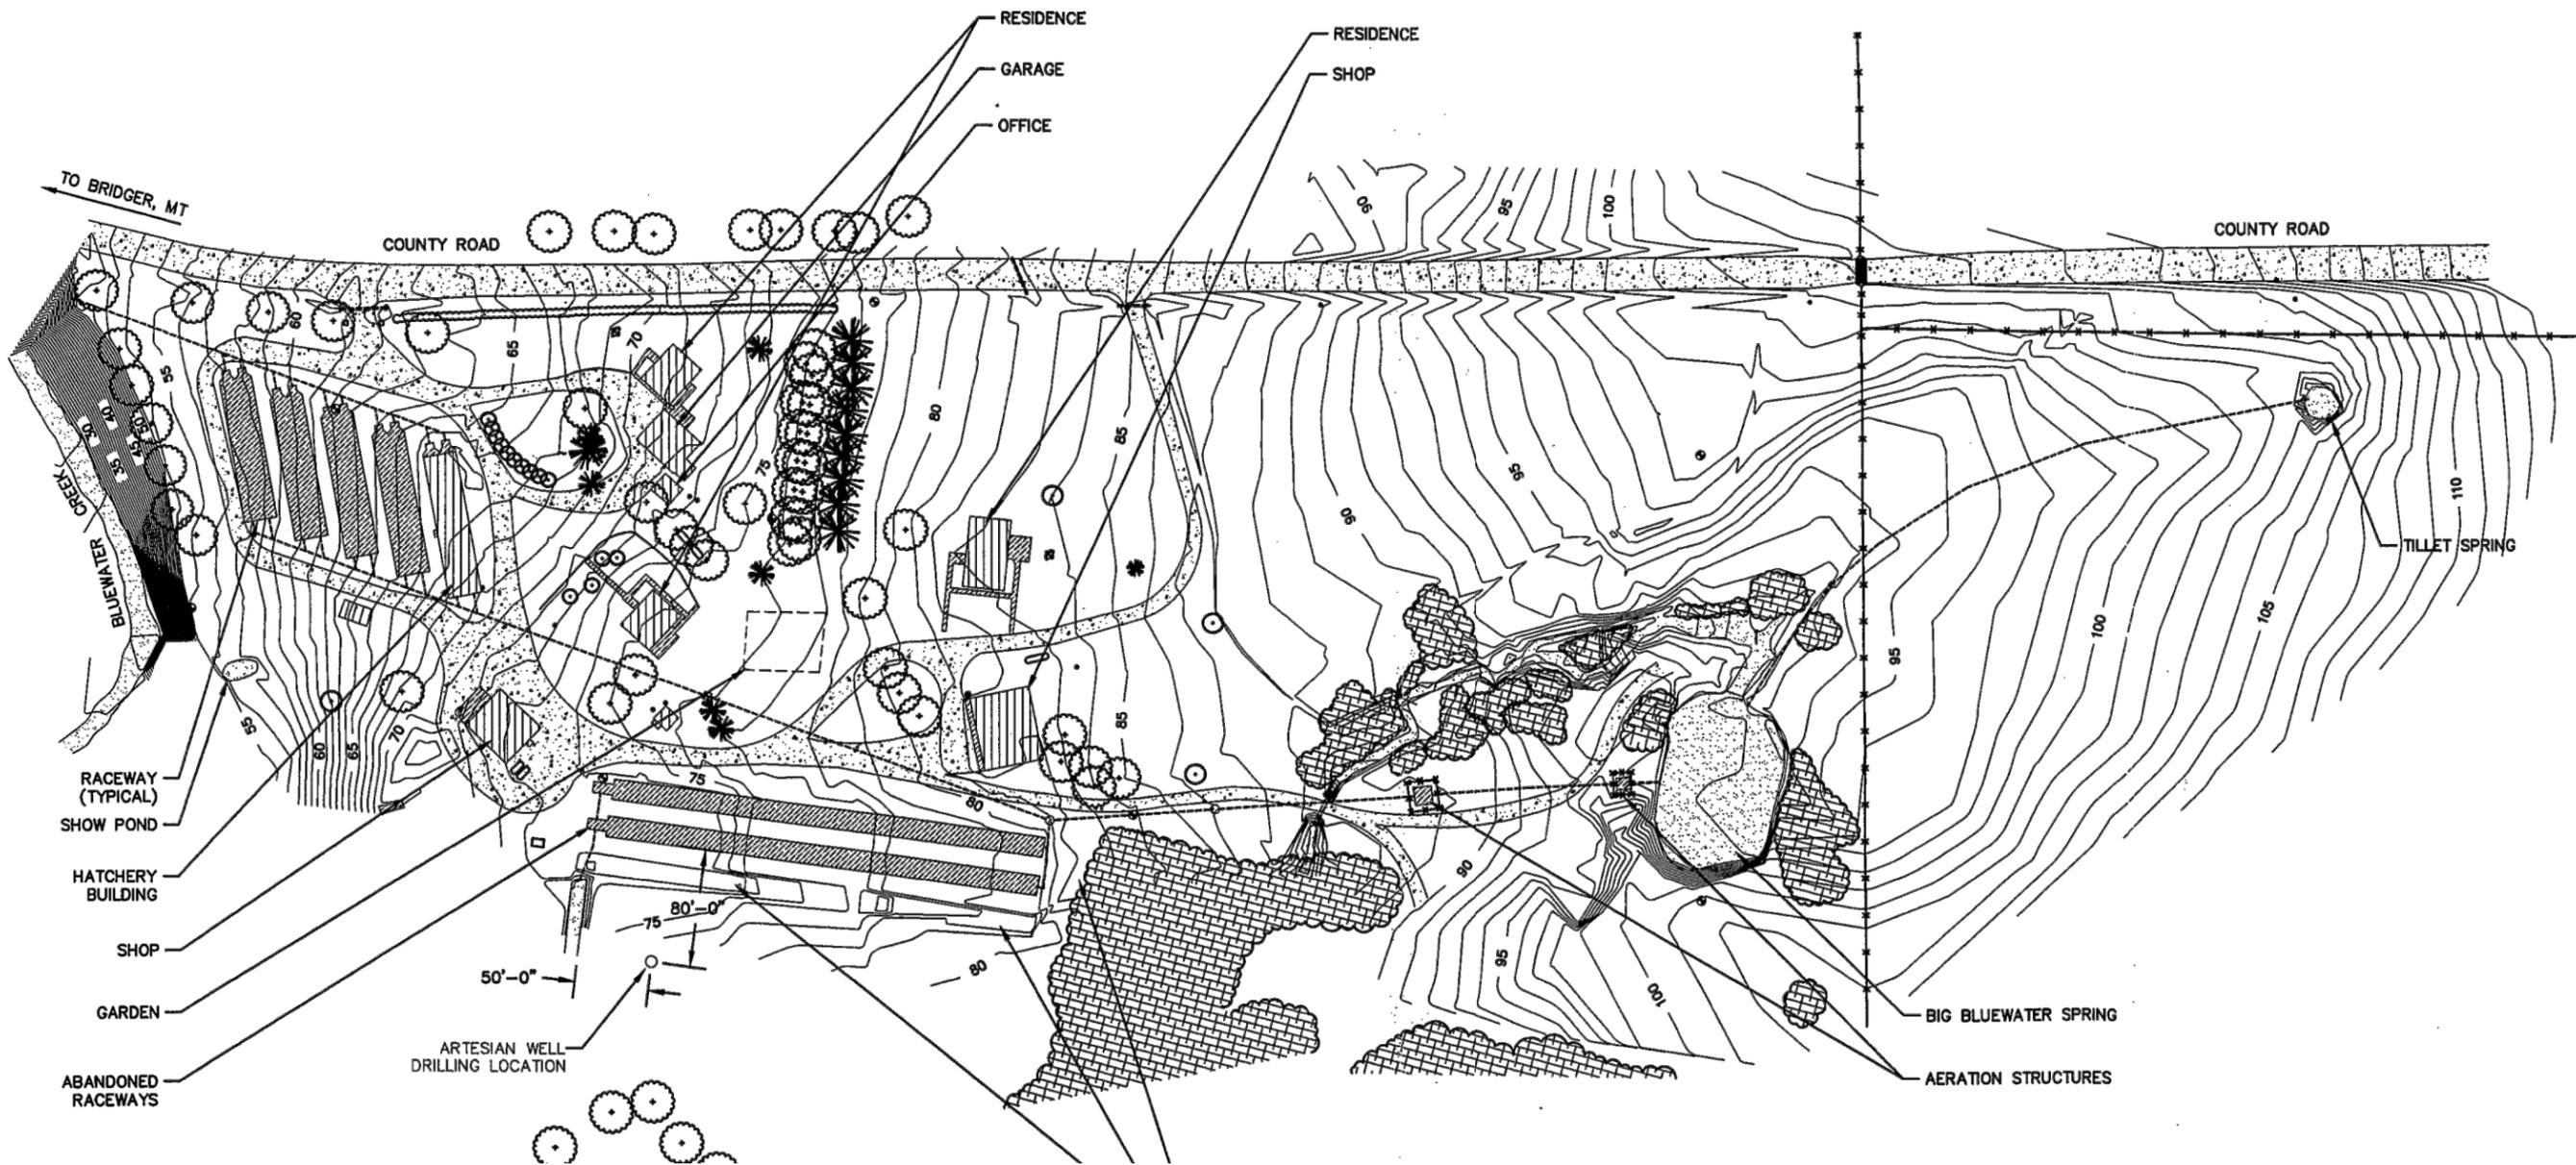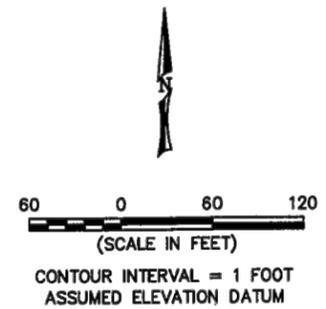

SYM	REVISION	BY	APPR. DAT

BRAUN INTERTEC MARCH, 1996
 DESIGNED BY DATE
 J. LARSON, P.E. 95-70
 DRAWN BY PROJECT NO.
 BRAUN INTERTEC WELLOC
 CHECKED BY FILE NO.




FIGURE TITLE
**BLUEWATER
 TROUT HATCHERY
 WELL LOCATION PLAN**



?	?	?	?
DRAWN BY:	DATE:	REVISED BY:	DATE:
?	?	APPROVED BY:	DATE:
CHECKED BY:	DATE:	APPROVED BY:	DATE:



BLUEWATER SPRINGS TROUT HATCHERY
 ARTESIAN WELL AS-BUILTS - EXISTING TOPOGRAPHY

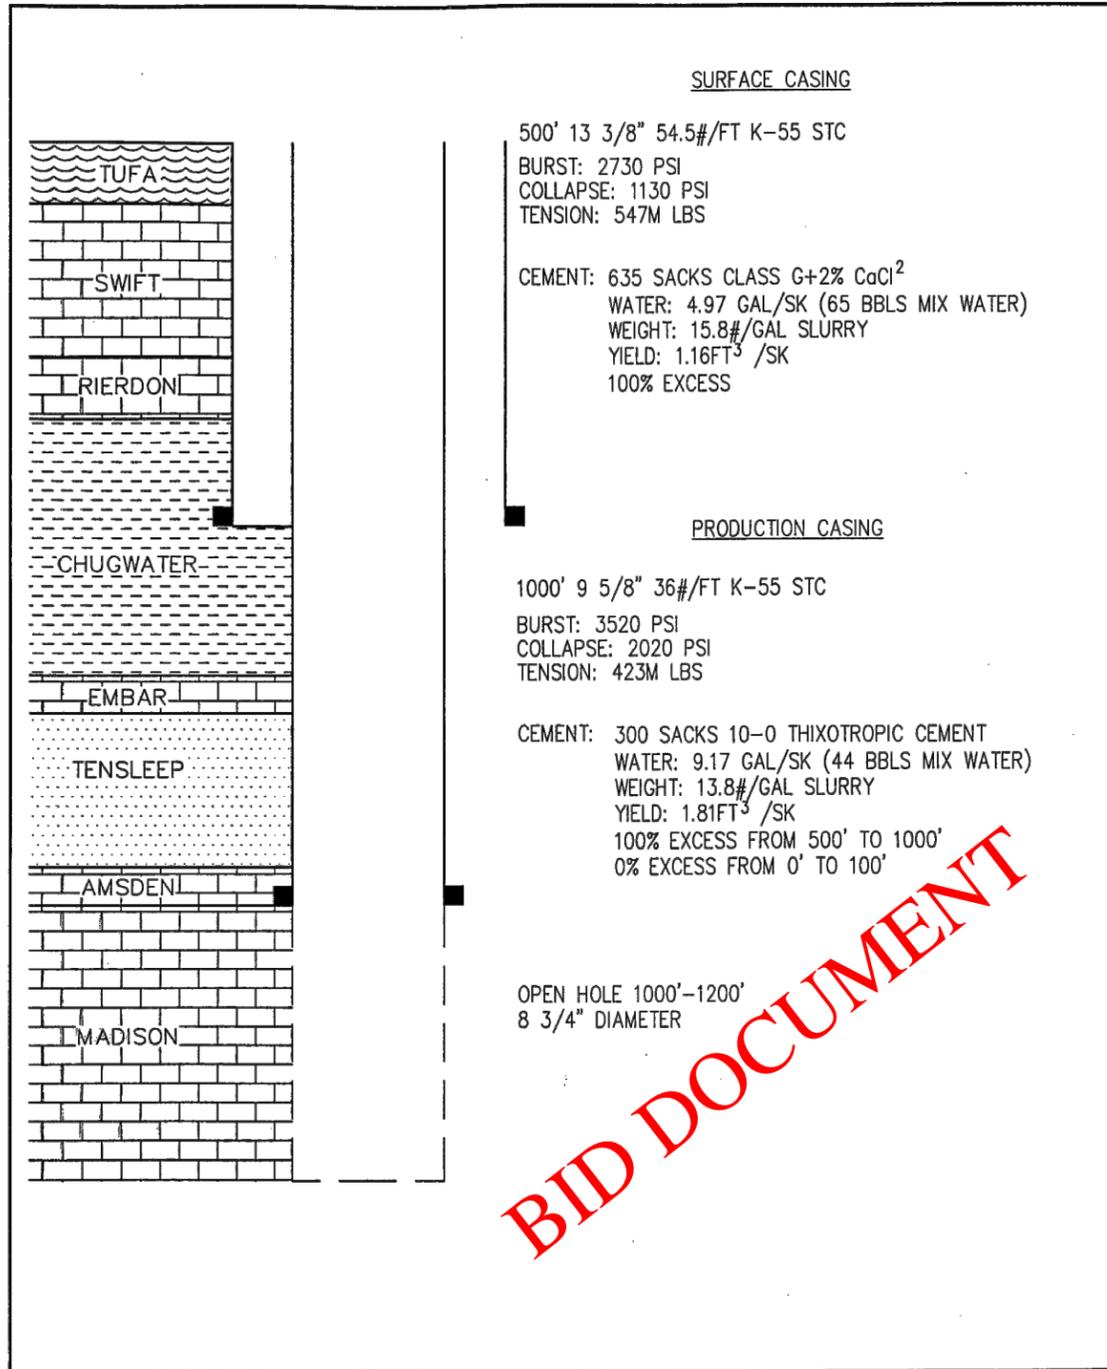

BID DOCUMENT

	BLUEWATER SPRINGS TROUT HATCHERY		
	ARTESIAN WELL		
	SEC 9, T6S - R24E		
	CARBON COUNTY, MONTANA		
	INT	DATE	SHEET
DRAWN BY: TJO	04/15/96	2	
APP'D BY: SAB	04/15/96	OF	
JOB No. BHEX-95-220		3	
DWG. No. 95220		FIGURE #	
SCALE N/A		2	

WELL LOG

DRAWN BY: ?	DATE: ?	REVISED BY: ?	DATE: ?
CHECKED BY: ?	DATE: ?	APPROVED BY: ?	DATE: ?



BLUEWATER SPRINGS TROUT HATCHERY
 ARTESIAN WELL AS-BUILTS - WELL LOG



PICTURE 1 - FACING SOUTH

PICTURE 3 - FACING WEST



PICTURE 2 - FACING SOUTH

PICTURE 4 - FACING NORTH



?	?
DRAWN BY:	DATE:
?	?
CHECKED BY:	DATE:

REVISD BY:	DATE:
APPROVED BY:	DATE:

APPROVED BY:	DATE:
APPROVED BY:	DATE:



**Montana Fish,
Wildlife & Parks**

BLUEWATER SPRINGS TROUT HATCHERY
ARTESIAN WELL AS-BUILTS - PICTURES



SHEET: 6 of 6